

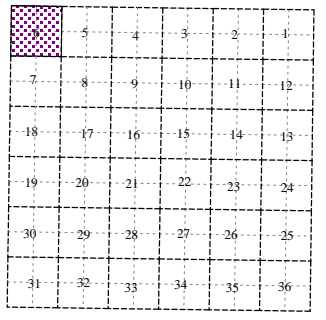
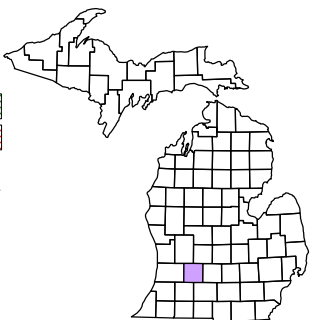


Prairieville Township  
T 1 N R 10 W  
Barry County  
Michigan

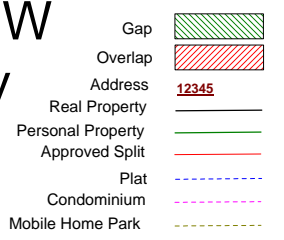

Section 06  
08-12-006-  
Scale 1" = 400'

This tax map was compiled for tax administration purposes from county and township records. It does not represent a land survey. Barry County Land Information Services 220 West State Street, Hastings MI 49058 (269) 945-1292 or http://www.barrycounty.org/

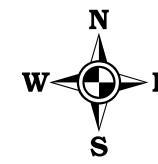

November 1996  
Revised May 1998  
Revised September 2000  
Revised August 2002  
Revised November 2003  
Revised January 2005  
Revised April 2006  
Revised May 2008

All dimensions are from tax roll unless noted below.  
D = deeded M or S = surveyed  
SR = Surveyor's Record prior to 1915  
GLO = Government Land Office circa. 1830

08-12-006-022-00 & 024-00 have point of beginning errors (77.5 --> 44.5) and should be combined into new parcel B of split #061204

08-12-006-023-00 needs to include gap parcel to the east and can be described as its three daughter parcels from split #061204.

08-12-006-021-00 does not exclude 021-10, 025 (addition), 021-15, & 023, correction reads from Whitman Moored survey of 12/15/1987.

08-12-006-029-00 does not close because it is missing second to last course.

08-12-006-017-00 needs to exclude sale to 017-05 in #200711050003873.

08-12-006-017-05 needs to include lake parcel deeded to it from 017-00 in #200711050003873

08-12-006-086-00 needs to include adjacent gap parcel from R#1134662.

08-12-370-002-00 has been changed by court order and plat amendment and should include gap.

08-12-370-001-00 has been changed by court order and plat amendment and should include gap.

08-12-006-083-00 does not close because it is missing its last course.

GAP known as the "Smith Lot" at the end of Boniface Point Drive.

GAP is access lot for back lot owners on Boniface Drive which needs a placeholder.

08-12-006-061-00 has a typo; the measure of 45 feet should be 48 feet.


08-12-006-044-00 is missing a course direction. Replace "TH 19D-38M W 150 FT" with "TH S19°38'W 150FT".

08-12-006-045-00 is missing a course direction. Replace "TH 19D-38M W 150 FT" with "TH S19°38'W 150FT".

08-12-006-051-00 is missing the second half of the description and has been surveyed for R#1007506.

GAP is access lot for back lot owners on Sycamore Drive which needs a placeholder.

08-12-006-067-00 is missing its course bearings from survey

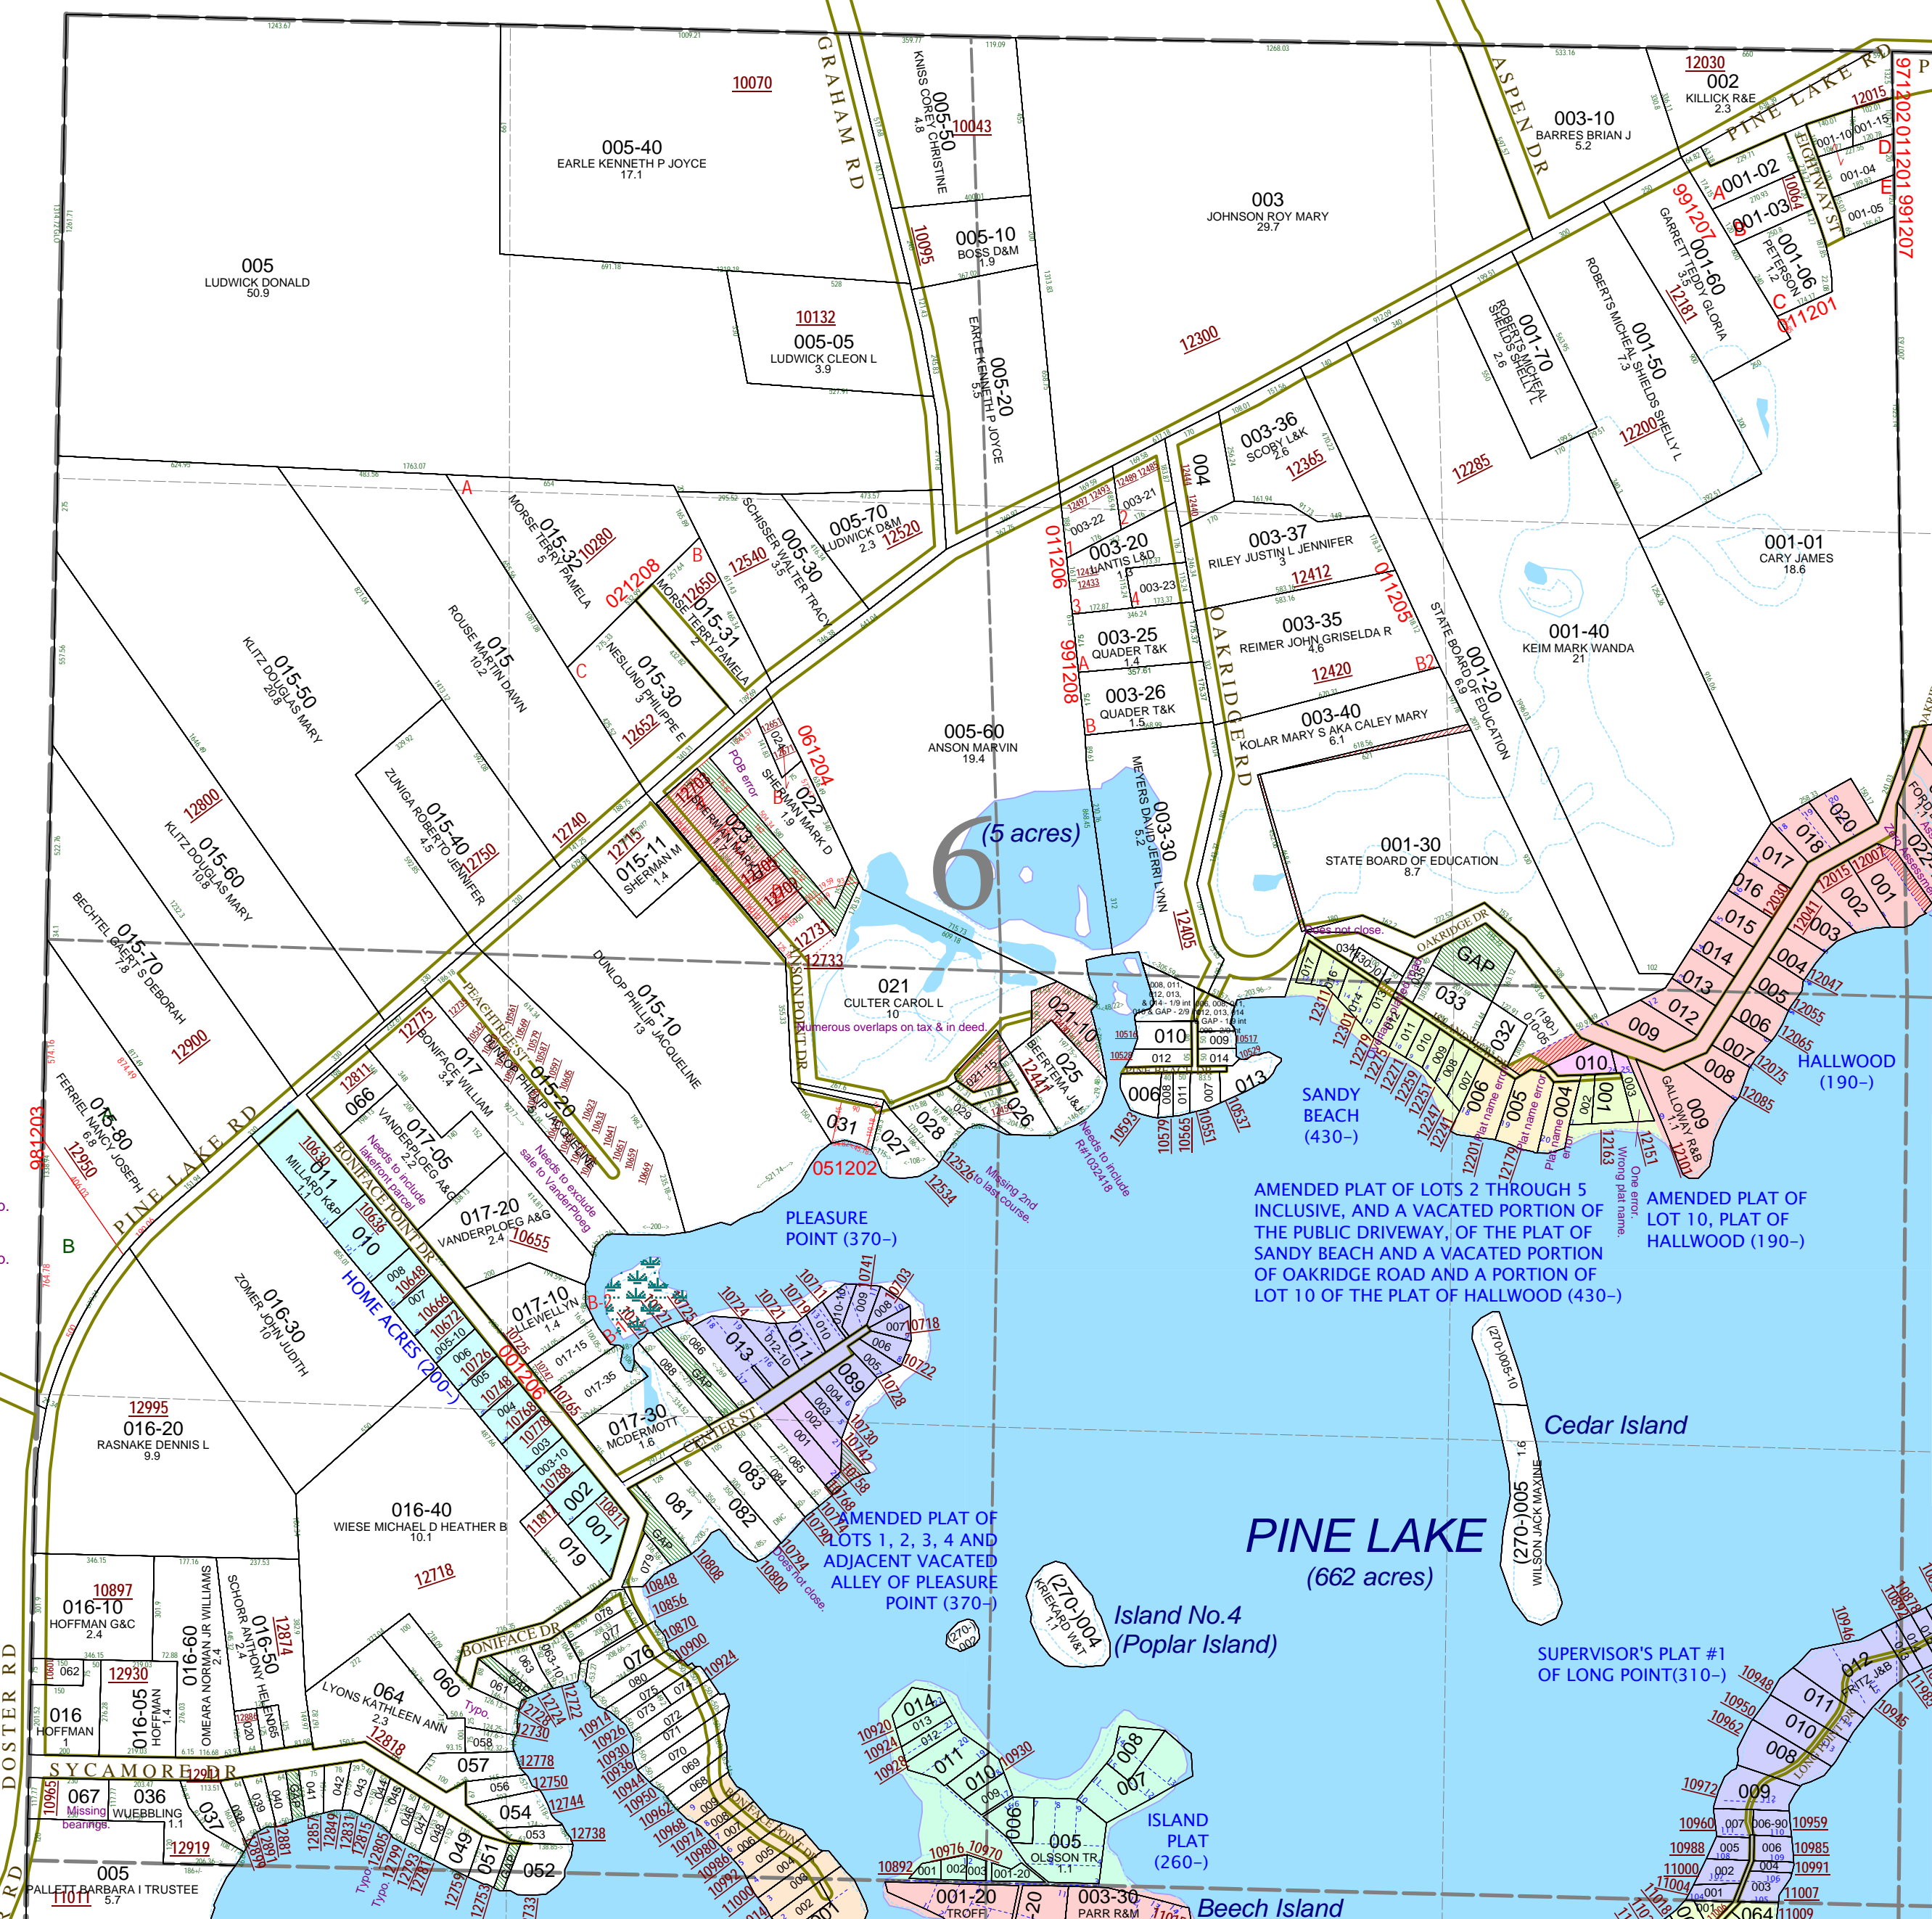

08-12-006-003-36 has a typo in the description on two of the courses. See mortgage in R#1121735 which combines the descriptions.

08-12-190-001-00 should not include 2nd description because there is no circuit court order vacating Island Drive.

GAP owned by the Estate of Susanna L. Hall. Last deed is find is to Ernest L. (deceased L.1950-507) & Susanna L. Hall (deceased L.1958-8399) in L.202-109 as part of a bigger parcel.

08-12-006-034-00 does not close and should read as parcel C of deed in L.668-100.

08-12-006-033-00 has an error in course to point of beginning and a repeated measurement and should read as deeded in # 20071004-0002728.

08-12-430-013-00 needs to exclude platted road from description as it reads in #20070802-0000395.

08-12-190-010-00 has been re-platted out of judgment-order in R#1047364 and should reflect court ordered replat.

08-12-190-010-05 has an error in third bearing and claims a platted road which has not been vacated by Circuit Court.

08-12-006-006-00 needs to describe the 1/9th interest of the common lot as laid out by partition survey by Fear & Hoke in M-5863.

08-12-006-007-00 has a poor, vague tax description and should reads as R#1122116.

08-12-006-008-00 only includes interest in garage lot as laid out by partition survey by Fear & Hoke in M-5863.

08-12-006-009-00 only includes 2/9th interest in bathroom lot and no interest in garage lot as laid out by partition survey by Fear & Hoke in M-5863.

08-12-006-010-00 has a 2/9th in the garage lot but no interest in boat lot as laid out by partition survey by Fear & Hoke in M-5863.

08-12-006-011-00 dropped the interest in both the garage and bathroom lot in the last quit claim deed when Alice J. Gilman survivor of Arthur E. Gilman makes the property joint with Arthur K. Gilman.

08-12-006-012-00 should not include 1/9th interest of the common lot as laid out by partition survey by Fear & Hoke in M-5863. See R#1062746.

08-12-006-013-00 should not include interest in bathroom or garage lot as laid out by partition survey by Fear & Hoke in M-5863. This was dropped in the conveyance between Reint L. & Dena M. VerSluis to Lewis & Geraldine VerSluis in L.235-222, where Reint & Dena received it in L.223-265.

08-12-006-014-00 does not include any interest in garage or bathroom lots as laid out by partition survey by Fear & Hoke in M-5863 on last deed in R#1049880

08-12-006-021-00 does not exclude 021-10, 025 (addition), 021-15, & 023, correction reads from Whitman Moored survey of 12/15/1987.

08-12-006-025-00 should now include parcel deeded in R#1032418 from 021-15 Geron to Beertema in a neighbor to neighbor sale.

08-12-430-003-00 has been re-described out of judgment-order in R#1047364.

08-12-430-004-00 has been re-described out of judgment-order in R#1047364.

08-12-430-005-00 has been re-described out of judgment-order in R#1047364.

08-12-430-006-00 has been re-described out of judgment-order in R#1047364.

AMENDED PLAT OF LOTS 2 THROUGH 5 INCLUSIVE, AND A VACATED PORTION OF THE PUBLIC DRIVEWAY, OF THE PLAT OF SANDY BEACH AND A VACATED PORTION OF OAKRIDGE ROAD AND A PORTION OF LOT 10 OF THE PLAT OF HALLWOOD (430-)

AMENDED PLAT OF LOTS 1, 2, 3, 4 AND ADJACENT VACATED ALLEY OF PLEASURE POINT (370-)

SUPERVISOR'S PLAT #1 OF LONG POINT (310-)